SC DES

APPROVAL TO OPERATE
Onsite Wastewater System

Permit ID: OSWW036832 v3.0
County: Pickens

Site: 25-5070 Blue Heron Custom Homes - Meadow Park Dr
Type Facility: Residential
Subdivision: Long View Carolina
Lot:
Gallons Per Day (GPD): 480

Site Address:
Meadowpark Drive
EASLEY, SC 29640

Program Code: CONVENTIONAL
System Code: 804 EZFLOW 1203H
TM #: 5019-13-03-5393
Water Supply: Municipal

ACTUAL INSTALLATION

The Final Approval will only be issued upon the system certified "as built" plan of the actual installation, and other supporting documentation as required.

FINAL APPROVAL

ANTHONY REDMON, REDMON GRADING (License No:23-367-23243)

(Licensed Septic Installer and License Number)

12/19/2025

(Installation Date)

Comments:

Office Use

THIS CERTIFICATE OF FINAL APPROVAL IN NO WAY GUARANTEES THE LIFE OF THE SYSTEM OR THAT IT WILL FUNCTION PROPERLY UNDER ANY OR ALL CONDITIONS.

Approved By: Brenna Greenwood

Date: December 19, 2025

Information collected on this form is subject to public scrutiny or release and the Freedom of Information Act

Instructions For Approval To Operate

1. This form should be utilized by Department Staff when approving a final inspection of an onsite wastewater system.
    a. Permit ID.: Onsite wastewater system permit number
    b. County: County where the onsite wastewater system will be located
    c. Name: Applicant's name
    d. Type Facility: Type of facility (house, mobile home, apartment, restaurant, etc)
    e. Subdivision: Name of subdivision
    f. Lot: Lot number
    g. Gallons Per Day (GPD): Peak sewage flow rate
    h. Address: Applicant's current mailing address
    i. Site: Property address where the onsite wastewater system will be located
    j. Program Code: Program code of the system being installed
    k. System Code: Code of the system being installed
    l. TM No.: Tax map number of the site on which the onsite wastewater system will be located
    m. Water Supply: Type of water supply (public or private)
2. This form must be signed and dated by the Department staff member issuing the approval.

Retention Schedule Series Number: 07335, *Onsite Wastewater System Application and Permit Records*

SC DEPARTMENT of ENVIRONMENTAL SERVICES

Final Inspection
Onsite Wastewater System

Permit ID: OSWW036832
County: Pickens

Name: _____
Type Facility: Residential
Subdivision: _____
Lot: 71 Gallons Per Day (GPD): 480

Address: Meadowpark Dr
Site: Easley SC 29640

Program Code: 100
System Code: 8014
TM #: 5019-13-03-5993
Water Supply: Municipal


FINAL INSPECTION and ACTUAL INSTALLATION (Insert Drawing Below) (NTS)

Installer: Redmon Grading
Septic Tank Mfr. & Size: Gillespie 1000
~~Pump Chbr Mfr. & Size:~~ _____
~~Pump Mfr:~~ _____
~~Pump Model:~~ _____
~~Grease Trap Mfr:~~ _____
Alt Product & Model: EZ Flow
Aggregate Type: EZ Flow
Agg Depth (in): 12
Trench Width (in): 36
Trench Depth (in): 30
~~Fill Cap:~~ ☐Yes ☐No

~~Well Inst:~~ ☐Yes ☐No
~~Well Dist (ft):~~ _____
Building Dist (ft): 65
Property Dist (ft): 7
~~Water Dist (ft):~~ _____

Elevation Readings:
Plumbing Stubout: 3'3
Septic Tank Inlet: 3'9
Septic Tank Outlet: 3'11.5
Pump Chamber Inlet: _____

Grease Trap Readings:
~~Stubout:~~ _____
~~Inlet:~~ _____
~~Outlet:~~ _____
~~Septic Tank Inlet:~~ _____

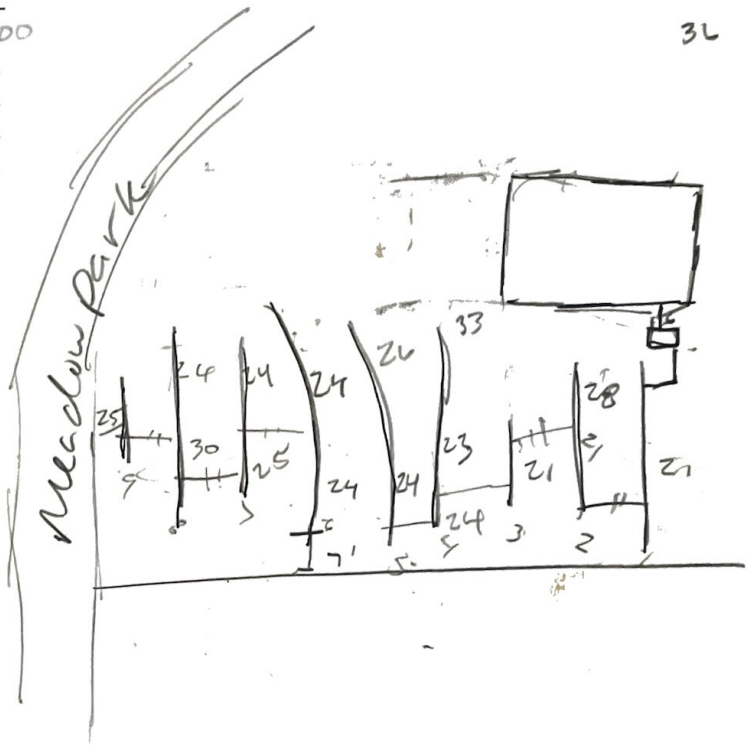

Trench Information:

Trench No.:	Trench Length:	Elevations:
1	30	5'4 5'4
2	85	6'4 6'4
3	30	6'8 6'8
4	75	7'4.5 7'4
5	65	8'7 8'7
6	50	8'10 8'10
7	30	9'4 9'4
8	25	9'8 9'8

9 10 9'10.

Inspected By: Breanna Greenwood
☒ Dept. Staff ☐ Installer

Comments:

Installer
Printed Name: // License #: 23-361-23243

I hereby certify the system was installed in accordance with the referenced permit and R.61-56.

Installer Signature: _____ Date: 12/18/25

THIS IS NOT AN APPROVAL TO OPERATE

THIS FORM MUST BE COMPLETELY FILLED OUT AND SUBMITTED TO THE LOCAL SCDES REGIONAL OFFICE WITHIN 48 HOURS OF SYSTEM INSTALLATION
THE SYSTEM CANNOT BE PLACED INTO OPERATION UNTIL AN OFFICIAL APPROVAL TO OPERATE IS ISSUED BY A DEPARTMENT REPRESENTATIVE.

Personal information provided on this form is subject to public scrutiny or release.